

AGENDA

Planning & Zoning Commission

Community Chambers, 20727 E. Civic Parkway
June 14, 2023
6:00 PM

Pursuant to A.R.S. § 38-431.02 notice is hereby given to the members of the Planning Commission and to the public that the Planning Commission will hold a meeting open to the public as set forth above.

The public can continue to watch the meeting live streamed at QueenCreek.org/WatchMeetings by selecting "video" next to the applicable meeting (once the meeting begins).

The Chairman or other presiding officer at the meeting may change the order of Agenda Items and/or take items on the Agenda in an order they determine is appropriate. Some members of the Commission and staff may attend electronically.

REGULAR SESSION

- 1. Call to Order:
- **2. Roll Call:** One or more members of the Commission may participate electronically or telephonically.
- 3. Pledge of Allegiance:
- 4. Public Comment: Members of the public may address the Planning Commission on items not on the printed agenda and during Public Hearings. Comments may also be sent to PublicComment@ QueenCreekAZ.gov by 5:30 p.m. the day of the meeting (limited to 500 words identify your name, address and whether you wish your comment to be read at the meeting or just submitted as part of the written record). Members of the Commission may not discuss, consider, or act on any matter raised during public comment.
- **5. Consent Agenda:** Matters listed under the Consent Agenda are considered to be routine and will be enacted by one motion and one vote.
 - A. Consideration and possible approval of the May 10, 2023 Planning Commission Meeting Minutes
 - B. Discussion and Possible Action on P23-0025 Arise Veterinary Hospital Comprehensive Sign Plan Amendment, a request from Steve Wiley of Triangle Sign Services for approval of a Comprehensive Sign Plan Amendment for Heritage Square located south of the southeast corner of Rittenhouse and Ellsworth roads.
- 6. Public Hearing:
 - A. None

- 7. Final Action:
 - A. None
- **8. Items for Discussion:** These items are for Commission discussion only and no action will be taken. In general, no public comment will be taken.
 - A. None
- 9. Administrative Items:
 - A. Recent Activity Update
- **10. Summary of Events from Members of the Commission and Staff:** The Commission may not deliberate or take action on any matter in the "Summary" unless the specific matter is properly noticed on the Regular Session Agenda.
- 11. Adjournment of the Regular Session.

WORK STUDY SESSION

- 12. Call to Order:
- **13. Roll Call:** One or more members of the Commission may participate electronically or telephonically.
- **14. Items for Discussion:** These items are for Commission discussion only and no action will be taken. In general, no public comment will be taken.
 - A. Transportation Department Update (Mohamed Youssef).
- 15. Adjournment of the Work Study Session.

I, Erik Swanson, do hereby certify that I caused to be posted this 8th of June, the Agenda for the June 14, 2023 Regular Session and Possible Work Study Session of the Queen Creek Planning & Zoning Commission at Town Hall and on the Town's website at www.queenCreekAZ.gov.

Erik Swanson	, Planning Manager	

The Town of Queen Creek encourages the participation of disabled individuals in the services, activities, and programs provided by the Town. Individuals with disabilities who require reasonable accommodations in order to participate should contact the Town Clerk's Office at (480) 358-3000.



Minutes Planning & Zoning Commission

Community Chambers, 20727 E. Civic Parkway Wednesday, May 10, 2023 6:00 PM

REGULAR SESSION

1) Call to Order:

The meeting was called to order at 6:01 p.m.

2) Roll Call:

PRESENT:

Alex Matheson Jeff Nielson Lea Spall Troy Young David Gillette Leah Gumm

Alex Matheson attended via WebEx

- 3) Pledge of Allegiance:
- 4) Public Comment:

None.

5) <u>Consent Agenda:</u>

5.A) Discussion and possible action on the April 12, 2023 Planning Commission Meeting Minutes.

Department: Development Services

Minutes 04-12-23.pdf >>>

5.B) Discussion and Possible Approval of P22-0284 Queen Creek Station South Commercial Comprehensive Sign Plan, a request from Michael Donada (Signs

Plus) for approval of a Comprehensive Sign Plan at a commercial development on approximately 9.7 acres, located at the southeast corner of Ellsworth and Walnut roads.

Department: Development Services

Staff Report >>>

Aerial Exhibit.pdf

QC Station South Commercial Comprehensive Sign Plan.pdf

5.C) Public Hearing and Possible Action on P23-0048 Site Plan and Preliminary Plat approval, a staff initiated text amendment to Section 3.3 Site Plan and Final Subdivision Review of the Zoning Ordinance.

Department: Development Services

Staff Report >>>

Chair Gillette opened the public hearing for Consent Item C. There were no comments and the public hearing was closed.

MOTION: To approve the Consent Agenda RESULT: Approved unanimously (6-0)

MOVER: Troy Young **SECONDER:** Lea Spall

AYES: Alex Matheson, Jeff Nielson, Lea Spall, Troy Young, David Gillette, Leah

Gumm

6) Public Hearing:

6.A) Public Hearing and Possible Action on P22-0256 Rittenhouse Commons 2 PAD Rezone, a request from Greg Davis (iPlan Consulting) to PAD Rezone from C-2 (General Commercial) to MDR/PAD (Medium Density Residential) for a 166 lot single-family townhome development on approximately 16.5 acres located at the northeast corner of Sossaman and Rittenhouse roads.

Department: Development Services

Staff Report >>>

Aerial Exhibit.pdf >>>

General Plan Exhibit.pdf

Current Zoning Exhibit.pdf >>>

Proposed Zoning Exhibit.pdf >>>

Development Plan.pdf >>>

Landscape Plan.pdf >>>

<u>Typical Alley Exhibit.pdf</u>

Conceptual Elevations.pdf >>>

Project Narrative.pdf

Neighborhood Meeting Summary.pdf

Public Comment.pdf >>>

Planner II, Steven Ester presented the Rittenhouse Commons PAD2 rezone request. He outlined the project location, zoning designation and the surrounding properties. He noted that it is surrounded by the Union Pacific Railroad, the existing Cortina subdivision to the west and several industrial areas. He said the request is to rezone the site from C-2 General Commercial to MDR/PAD Medium Density Residential for a 166 lot single-family home townhome development on 16.5 acres. Mr. Ester said the General Plan designation is Commercial, however because the project site is under 20 acres a General Plan Amendment is not needed.

Mr. Ester said it is a triangular shaped site that was originally designated as commercial and failed to develop and was acquired by the current applicant. Mr. Ester provided details on the landscape buffers the walking trails and the location of the SRP easement on the site . He said the project has 419 parking spaces with 2-car garages that share a common driveway and noted that the garages will not face Rittenhouse Road.

Mr. Ester said there will be two full access points, 45% open space and he discussed the conceptual elevations and unit types that are proposed. There is one deviation being requested for a reduction to the rear setback from ten (10) feet to three (3) feet due to the required placement of utility lines. Mr. Ester mentioned that the MDR designation and development standards cover a broad range of product types and ownership formats and staff anticipates that requests for deviations may occur.

Mr. Ester said two neighborhood meetings were held (in 2021 and 2023) with six residents in attendance. Concerns were in regards to increased traffic; road improvements on Sossaman Rd; decrease in surrounding property values; school capacity and water assurance. Staff has received 5 emails in opposition and 1 email in support of the project at this time. He also noted that Condition #10 in the staff report is voided and has been removed. The next step will be the Town Council meeting on June 7, 2023.

Commissioner Spall asked if there will be a signal at the main entry point on Sossaman Road. Mr. Ester said there are no signals at either access point and both entries allow for full-turning movements in and out of the development.

Applicant Greg Davis, IPlan Consulting, discussed the history of the parcel and said because of the unique shape, the proximity to the railroad, minimal traffic and many other major existing commercial centers close by that it has struggled to attract commercial users. He said a financial analysis was done and the study suggested a different use other than commercial. Mr. Davis briefly reviewed the access points; open space; amenities and the products being offered. He said the design is compatible with the neighborhood.

Mr. Davis addressed the neighborhood concerns which included density, traffic and road improvements. He said the road improvements that are proposed will improve conditions in the area.

Commissioner Young asked what the price point and rents will be. Mr. Davis said they are not rentals, it is a for sale product, and the price range will likely be somewhere between \$350- \$500K.

Vice Chair Nielsen asked if the residents can park in the driveway or is it constricted to garage parking. Mr. Davis said garage parking is required and no on-street parking is allowed.

Chair Gillette opened the public hearing. There were no comments and the the public hearing was closed.

MOTION: To approve P22-0256 Rittenhouse Commons 2 PAD Rezone, subject

to the Conditions of Approval included in this report with the

omission of Condition #10.

RESULT: Approved unanimously (6-0)

MOVER: Jeff Nielson SECONDER: Leah Gumm

AYES: Alex Matheson, Jeff Nielson, Lea Spall, Troy Young, David Gillette, Leah

Gumm

6.B) Public Hearing and Possible Action on P22-0072, P22-0073, and P22-0226 Cobblestone Carwash and Gravity Coffee Site Plan, Conditional Use Permit, and PAD, a request from Jesse Macias (M3 Design) for a Site Plan, Conditional Use Permit, and PAD for a carwash and drive-thru coffee shop on approximately 2.91 acres located at the northeast corner of Ellsworth Road and Hunt Highway.

Department: Development Services

Staff Report >>>

Aerial Exhibit.pdf >>>

General Plan Exhibit.pdf >>>

Current Zoning Exhibit.pdf

Project Narrative.pdf >>>

Site Plan.pdf >>>

Landscape Plan.pdf

Building Elevations and Renderings.pdf >>>

Neighborhood Meeting Summary.pdf >>>

Public Comments.pdf >>>

Planner II Steven Ester presented the Site Plan, Conditional Use Permit and PAD for Cobblestone Carwash and Gravity Coffee. He outlined the surrounding properties and said the zoning is designated C-2 General Commercial after the annexation from Pinal County in 2018. The PAD is tied to the coffee shop site to allow one landscape buffer deviation along Hunt Highway. Mr. Ester reviewed details of the Site Plan which proposed 34 parking spaces and 22% open space. He reviewed the carwash queue of 435 feet and and the coffee shop queue of 275 feet. He discussed the two access points on Hunt Highway and reviewed the elevations of each building. He said they will use a variety of colors and masonry to provide some consistency between users.

Mr. Ester reviewed the location of the proposed PAD deviation to allow a reduction of the required arterial landscape buffer along Hunt Highway from 30 feet wide to 18 feet on a portion of the frontage near the Gravity Coffee site only. He noted that all other landscape buffers and open space standards are met. He said staff does not support the deviation.

Mr. Ester said a neighborhood meeting was held with 6 residents in attendance. Concerns were in regards to improvements of the adjacent roads, existing storm drainage and washout areas along the site, noise mitigation from the carwash and minimal lighting and signage was preferred because of the proximity to the base of the San Tan Mountain. Staff has received 2 emails in opposition of the project. This item will go to the June 7, 2023 Town Council meeting.

Vice Chair Nielsen asked when the architectural review will occur. Mr. Ester said it has already been done and what you see is what is applied for.

Commissioner Spall inquired about access from San Tan Valley and how do they enter the site and also asked for more information regarding the four lanes for the drivethru. Mr. Ester said there is full access from San Tan Valley with a left turn in. He said the drive-thru lanes are unique to the brand and he will let the applicant speak on that.

Applicant Jesse Macias, M3Design said he has been working with staff for nine months and he feels the collaboration has created a better project and end result. He provided snapshots of the site and briefly discussed access and neighborhood outreach. He said the request for a PAD has to do with the landscape setback in that area. He described the double drive-thru concept used for the coffee shop to provide better functionality and the drive-thru will be staffed with live people only without menu boards.

Mr. Macias said the reason for the deviation from the 30 foot setback is unique to the site and provided examples of existing hardships which are mainly due to existing drainage issues. He said they are improving Ellsworth Road from Hunt Highway to the south edge of their property and addressed drainage mitigation and costs. He reviewed the landscaping being done overall on the entire site and added that the properties to the east (Dunkin Donuts and Earnhardt) do not meet the 30 feet setbacks. He said they do not think the deviation will impact surrounding properties.

Chair Gillette asked for examples of other establishments that use the two lanes in and two lanes out for drive-thrus. Mr. Macais said more and more fast food users are doing the double drive thru but he cannot pinpoint an exact location.

Chair Gillette asked Mr. Macias if he can confirm that that Town allowed setback deviations in the past for the properties he mentioned to the east. Mr. Macias did not know how the deviations happened, he said there was a 30-foot easement approved, but he said the end product does not have the 30 feet and said staff may be able to address that.

Mr. Ester responded that the project was annexed from the County and there was some previous influence from previous design up to that point. He said the 30 feet was interpreted as an easement and it was not a deviation. The reason that you are not seeing a true 30-feet of landscaping is because the easement includes the sidewalk, but there is a 30-foot access easement on paper for those projects.

Commissioner Young asked if the 18 feet that is being requested by the applicant includes the 6 foot sidewalk.

Mr. Macias replied no, the right of way line is where it starts and the sidewalk is not included in the 30-feet landscape.

Commissioner Young had concerns about safety on that corner and asked if the drainage area can be dug down deeper to bring a little more room for the project. Mr. Macias said they looked at all options but because of shallow drainage flows they were not able to. He added that they added a decel lane and an acceleration lane to mitigate concerns about speed in that area.

There was additional discussion on the double drive-thru lanes and Mr. Macias provided more information on ordering and exiting the coffee shop.

Chair Gillette opened the public hearing There were no comments and the hearing was closed.

Chair Gillette provided additional comments on the setback deviation and said he understands the previous zoning was inherited from Pinal County, but said he does not want to make deviations the norm. He also voiced concerns regarding safety in that area.

Commissioner Nielsen felt that the site may not have been engineered enough and asked if the building could be moved over some and come up with a compromise.

MOTION: To approve P22-0072, P22-0073, and P22-0226 Cobblestone Carwash

and Gravity Coffee Site Plan, Conditional Use Permit, and PAD,

subject to the Conditions of Approval outlined in this report.

RESULT: Approved (4-2)

MOVER: Lea Spall

SECONDER: Alex Matheson

AYES: Alex Matheson, Jeff Nielson, Lea Spall, David Gillette

NAYS: Troy Young, Leah Gumm

6.C) Public Hearing and Possible Action on P22-0260 Pecan Lake Entertainment Center PAD Rezone, a request from Greg Davis (iPlan Consulting) to rezone approximately 2 acres from R1-43 to AT (Agritainment) to be incorporated into the larger 12-acre Pecan Lake Planned Area Development (PAD) and a request to update the Pecan Lake PAD development plan to incorporate a variety of new entertainment uses. The subject site is located west and north of the northwest corner of 206th Street and Riggs Road.

Department: Development Services

Staff Report >>>

Aerial Exhibit.pdf >>>

General Plan Exhibit.pdf >>>

Current Zoning Exhibit.pdf

Proposed Zoning Exhibit.pdf >>>

PAD Narrative.pdf

Conceptual Site Plan.pdf

Neighborhood Meeting Summaries.pdf >>>

Emails Opposition COMBINED.pdf

Emails Support COMBINED.pdf

Planning Administrator Erik Swanson presented an overview of the Pecan Lake Entertainment Center PAD Rezone request. He said there are two components to the request 1) rezone a 2-acre parcel from R1-43 to Agritainment and 2) update the larger Pecan Lake PAD development plan to incorporate a variety of new entertainment uses to establish the Pecan Lake Entertainment Center.

Mr. Swanson provided background history on the unique Agritainment Zoning District and said it brings together agritainment uses with entertainment and the applicant must be very specific with the use put on the property and the use must be requested. He explained what was originally approved for the location and said the

request tonight is to expand the permitted uses to include a zip line, ropes course, electric go-karts, wave pool, putting golf, parking lot and associated uses in the existing building. He addressed building height and parking. Mr. Swanson said the existing parking has 39 spaces and 175 spaces are proposed and the applicant is also working with the LDS church for additional parking. He presented the conceptual site plan and said if the project is approved the developer must submit a site plan application.

Mr. Swanson said there were two neighborhood meetings with 23 residents in attendance. Issues raised by residents concerned traffic; congestion in the 206th Road area; concerns about change to the original vision for Pecan Lake; noise; lighting and security given the proposed uses. Staff received 52 comments in support (22 were in close vicinity of the site) of the project and and 13 in opposition.

Ralph Pew, Pew & Lake, presented on behalf of Riggs Road LLC owner and developer of the Pecan Lakes Entertainment Center. Mr. Pew explained the purpose of the request and the unique qualities of an Agritainment District and related uses that are associated with it. He gave examples of other agritainment uses in the area and the associated uses. He said PLEC started as the Botanical Garden with an agritainment focus and uses are being added evolving over time. Mr. Pew said tonight we are asking for a recommendation on two questions 1) should the 2-acre parcel be rezoned to Agritainment to accommodate a 175 space parking lot for this facility and 2) should the PAD Development Plan that accompanied the case in 2018 be updated to allow a variety of new uses. Mr. Pew said this is the only portion of the zoning code that operates this way, where you need to apply for a PAD and Site Plan and designate the specific uses to be reveiwed and approved. He said that staff recommends approval.

Greg Davis, IPlan Consulting, presented information on the existing Botanical Garden and said the goal was to bring in other entertainment uses to expose people to the agritainment project with a focus on health and active play. He referred to the table of permitted uses and said the proposed uses fit within the table definitions. Mr. Davis spoke on the expansion plans for the Botanical Garden, which is the main agritainment focus, to help it succeed. He presented design concepts for the various buildings and entertainment features and said the buildings will have an agritainment themed design. Mr. Davis explained the activities that will take place including noise mitigation, compatibility to surrounding areas, traffic flow and proposed parking. He said neighborhood meetings concerns were all addressed including parking in Phase I which will be the first order of business.

Commissioner Young commented on the parking across from Caldwell's. He said he appreciates the noise mitigation and likes that the project offers more for kids to do. He said it is important to recognize the neighbor's concerns.

The following spoke in opposition of the project:

Troy Kastorff, 20644 E Natalie Way, Queen Creek, AZ 85142 Carrie Webber, 20652 E Natalie Way, Queen Creek, AZ 85142

The following spoke in favor of the project:

Kevin Petersen, 24833 S. 206th Place, Queen Creek, AZ 85142

Christian Talbot, 20939 E. Mockingbird Drive, Queen Creek, AZ 85152 Adrienne Browning, 20660 E Natalie Way, Queen Creek, AZ 85142 Ashlyn Edwards, 24872 S. 205th Place, Queen Creek, AZ 85142 Jeremy Wright, 20511 E. Sunset Court, Queen Creek, AZ 85142 Lacey Montierth, 24832 S. 206th Place, Queen Creek, AZ 85142 John Ward, 24774 S. 205th Place, Queen Creek, AZ 85142 Chance Howard, 20712 E Marsh Rd, Queen Creek, AZ 85142 Cameron Howl, 24349 S. 201st Ct, Queen Creek, AZ 85142

The following filled out a comment card but did not wish to speak, and were in support of the project:

Chris Hadji, 20494 E Via De Palmas, Queen Creek, AZ 85142 Susan Hadji, 20494 E Via De Palmas, Queen Creek, AZ 85142 Jordan Montierth, 24832 S. 206th Place, Queen Creek, AZ 85142

Sterling Tanner, 24873 S. 206th Place, Queen Creek, AZ 85142 - had concerns about noise

Chair Gillette closed the public hearing. The Commissioners had the following comments and questions:

Chair Gillette said he is sensitive to those adjacent to the project and said it is not an easy decision for the Commission. He said the Commission is an unbiased panel that considers all information presented.

Vice Chair Nielsen asked if the Town has a noise ordinance. Mr. Swanson said yes, the cutoff is 10 p.m. and noise levels are measured from the adjacent property line. He provided information on how residents can file complaints. Mr. Davis said the hours of operation are 10 a.m. to 10 p.m. He said a sound study was performed for each use which measured noise levels versus ambient noise and we were below levels and in compliance.

Commissioner Spall commented on the parking on 206th Street and noticed no parking signs on the road. She asked if similar signs can be placed on Natalie Way. Mr. Davis said that would be up to the Town but he would support that. Mr. Swanson said he can reach out to the traffic division regarding signage.

Commissioner Gumm said that this is a good use for the space. She said that she is active on social media and there are many comments that teenagers need more to do and this would help.

Commissioner Matheson concurred and said it is a good use for the area.

The following public comments were received and entered as part of the record:

C.S. Webber Email

<u>Troy Kastorff Email</u>

MOTION: To approve P22-0260 Pecan Lake Entertainment Center PAD Rezone,

subject to the Conditions of Approval included in this report.

RESULT: Approved unanimously (6-0)

MOVER: Troy Young SECONDER: Jeff Nielson

AYES: Alex Matheson, Jeff Nielson, Lea Spall, Troy Young, David Gillette, Leah

Gumm

7) Final Action:

None.

8) Items for Discussion:

None.

9) Administrative Items:

There were no administrative items or recent activity updates reported.

10) Summary of Events from Members of the Commission and Staff:

None.

The Commission took a brief recess at 8:20 p.m. and returned at 8:32 p.m.

11) Adjournment of the Regular Session.

The Regular Session Meeting adjourned at 8:33 p.m.

WORK STUDY SESSION

12) Call to Order:

The Work Study Session was called to order at 8:37 p.m.

13) Roll Call:

PRESENT:

Jeff Nielson

Lea Spall

Troy Young

David Gillette

Leah Gumm

ABSENT:

Alex Matheson

14) Items for Discussion:

A) Discussion on Industrial Design Guidelines (Erik Swanson, Planning Manager)

Mr. Swanson introduced the discussion on Industrial Design Guidelines. This subject was previously addressed in 2019 and is being reintroduced due to an increased interest in industrial development. The purpose is to ensure orderly development that corresponds with the high level of design in Queen Creek. The guidelines will provide prescriptive language and allow for flexibility depending on the development type. Mr. Swanson showed some renderings of existing and future projects that reflect the intent of the guidelines.

Mr. Swanson said the next steps are to continue to refine the guidelines based on Council direction and share ideas with stakeholders. It will come back to the Planning Commission when completed and then it will be presented to Council for a vote.

15) Adjournment of the Work Study Session.

The Work Study Session Meeting adjourned at 8:40 p.m.

TOWN OF QUEEN CREEK
David Gillette, Chair
ATTEST:
loy Maglione, Deputy Town Clerk
, Joy Maglione, do hereby cer fy that to the best of my knowledge and belief, the foregoing Minutes are a true and correct copy of the Planning & Zoning Commission Minutes of the May 10, 2023 Planning & Zoning Commission of the Queen Creek Town Council. If further cer fy that the mee ng was duly called and that a quorum was present.
Passed and approved on:



TO: PLANNING & ZONING COMMISSION

THROUGH: BRETT BURNINGHAM, DEVELOPMENT SERVICES DIRECTOR

FROM: ERIK SWANSON, PLANNING ADMINISTRATOR, MALLORY RESS, PLANNER I

RE: DISCUSSION AND POSSIBLE ACTION ON P23-0025 ARISE VETERINARY HOSPITAL

COMPREHENSIVE SIGN PLAN AMENDMENT, A REQUEST FROM STEVE WILEY OF TRIANGLE SIGN SERVICES FOR APPROVAL OF A COMPREHENSIVE SIGN PLAN AMENDMENT FOR HERITAGE SQUARE LOCATED SOUTH OF THE SOUTHEAST

CORNER OF RITTENHOUSE AND ELLSWORTH ROADS.

DATE: June 14, 2023

Suggested Action:

Move to approve P23-0025 Arise Veterinary Hospital Comprehensive Sign Plan Amendment, subject to the Conditions of Approval included in this report.

History:

October 12, 2016: Planning Commission approved case P16-0028, "Heritage Square Comprehensive Sign Plan".

April 21, 2021: Town Council approved cases P21-0007 and P21-0008, Heritage Square Veterinary Hospital Conditional Use Permit and Site Plan.

Project Information:

Project Name - Heritage Square Comprehensive Sign Plan Amendment (P23-0025)

Site Location - South of SEC of Rittenhouse and Ellsworth roads

Current Zoning - C-2 (General Commercial)

General Plan Designation - Commercial

Surrounding Zoning Designations:

North - Queen Creek Crossroads (C-2)

South - Heritage Square (C-2)

East - Rittenhouse Rd., Union Pacific Railroad (EMP-B & R1-43), Nauvoo Station (R1-6 & R1-8)

West - Heritage Square (C-2)

Net Acreage - 3.29 acres (approx.)

Building Area (Total) - 33,566 sq.ft. (approx.)

Discussion:

The Arizona Regional Intensive Care Veterinary Hospital (ARISE) building is a recently constructed two-story building within the Heritage Square commercial center. Heritage Square is an

approximately 14.5 acre commercial shopping center zoned C-2/PAD. The shopping center is comprised of 10 lots, most of which are developed. The Comprehensive Sign Plan for Heritage Square was approved in October 2016.

ARISE is a veterinary emergency and multispecialty facility that houses 11 different medical specialties including CT, MRI Trailer, three X-rays, C-Arm, and a Nu-boom. In conjunction with the approval of the conditional use permit and site plan for the veterinary hospital by Town Council in April 2021, two (2) lots within Heritage Square were tied to create one (1) lot for the ARISE building including the MRI Trailer and the associated parking lot.

The Comprehensive Sign Plan Amendment is requested to allow for the following deviations from the approved CSP: 1) increased sign area at the east building elevation, 2) increased aggregate signage, and 3) illuminated under canopy signage. Justification for these deviations is outlined below.

Increased Sign Area for East Elevation - The existing CSP allows for ½ sq. ft of sign area per lineal foot of building occupancy at side and rear elevations. The east elevation is considered a side elevation. The length of the east elevation of the ARISE building is 128.04 ft. Pursuant to the CSP the total sign area permitted for this elevation is 64.02 sq. ft. The applicant is requesting a total of 90.35 sq. ft. across two (2) signs. This is in excess of the allowable signage for the east elevation by 26.33 sq. ft. The east side of the building is the elevation most visible from Rittenhouse Rd. Given the critical nature of operations at ARISE, the increased sign area is necessary for customers to easily identify the veterinary hospital building while travelling on Rittenhouse Rd. Staff has reviewed the deviation and supports it as presented.

Increased Aggregate Sign Area - The maximum permitted aggregate sign area for a building within Heritage Square is 250 sq. ft., irrespective of the size of the building. The applicant is requesting an aggregate sign area of 300.26 sq. ft. This is in excess of the permitted total signage by 50.26 sq. ft. Prior to construction of the ARISE building, two (2) lots within Heritage Square were combined to create one larger lot, allowing for a building with a greater footprint than if constructed on one lot. The applicant is proposing signage at three elevations, with no signage proposed on the north elevation. The following sign allowances are permitted pursuant to the existing CSP at each building elevation as follows: North elevation – 83.43 sq. ft., South elevation – 257.69 sq. ft., East elevation – 64.02 sq. ft., West elevation – 64.46 sq. ft. Therefore the total allowed signage for the building, if the maximum aggregate stipulation was not a part of the CSP, is 469.6 sq. ft. The total aggregate sign area requested is well under this amount. The requested total signage is proportionate with the size of the building. Staff has reviewed the deviation and supports it as presented.

Illuminated Under Canopy Signage - The CSP allows for non-illuminated under canopy blade signs in front on a tenant's leased space and below the architectural canopy with a maximum size of 6 sq. ft. The applicant is requesting three (3) illuminated under canopy signs with one (1) under canopy sign proposed at the east elevation and two (2) proposed at the south elevation. The under canopy sign proposed at the east elevation is 19.5 sq. ft.. The same sign is proposed at the south elevation along with an additional sign that is 17.29 sq. ft. The applicant provides that these under canopy signs will serve the purpose of distinguishing between the "Pet Emergency" and the "Pet Specialty" entrances. This will provide clients with a clear visual of which entrance to use and assist in veterinary hospital staff accessing the patient as quickly as possible when a critical patient arrives. It is also crucial that these signs are illuminated because the majority of critical patients are generally received in the late evening hours. Staff has reviewed the deviation and supports it as presented.

Conditions of Approval:

- 1. This project shall be developed in accordance with the plans attached to this case and all the provisions of the Zoning Ordinance applicable to this case.
- 2. Any temporary signage shall be subject to review and approval under the Temporary Sign Permit application process.
- 3. Signage shall be permitted under a building permit, following approval of the Comprehensive

Sign Plan Amendment from the Planning and Zoning Commission.

4. Signage shall be maintained in a manner consistent with its initial installation.

Attachment(s):

- 1. Aerial Exhibit
- 2. Sign Package

Project Name: ARISE Veterinary Hospital CSP Amendment

Case Number: P23-0025

Hearing Date: June 14, 2023 (Planning Commission)





PROJECT SCHEDULE

	I NOSECT SCHEE			
	SIGN TYPE/ DESCRIPTION:	QTY.:	PG	
A.	A.1 - ILLUM. FACE-LIT STACKED CHANNEL LETTERS, FLUSH MOUNTED.	ONE (1)	5	
	A.2 - ILLUM. FACE-LIT STACKED CHANNEL LOGO AND LETTERS, FLUSH MOUNTED.	ONE (1)	5	
A1.	REMOVED FROM PACKAGE.			
B.	ILLUM. FACE-LIT LINEAR CHANNEL LETTERS, FLUSH MOUNTED.	ONE (1)	7	
C.	ILLUM. FACE-LIT CHANNEL LETTERS ON WIREWAY, UNDER-CANOPY MOUNTED "PET EMERGENCY"	TWO (2)	9	
C1.	ILLUM. FACE-LIT CHANNEL LETTERS ON WIREWAY, UNDER-CANOPY MOUNTED "PET SPECIALTY"	ONE (1)	11	
C2.	REMOVED FROM PACKAGE.			
D.	ALUM. FORMED PAN WITH PUSH-THRU LOGO/COPY FOR EXISTING MONUMENT SIGN @ HERITAGE LOOP.	TWO (2)	13	
D1.	ALUM. FORMED PAN WITH PUSH-THRU LOGO/COPY FOR EXISTING MONUMENT SIGN @ RITTENHOUSE RD.	TWO (2)	14	
	TOTAL SQ. FT. ALLOWED: 250 SQ. FT.			
	TOTAL APROVED SIGNAGE SQ. FT.: 173.17 SQ. FT.			
	PROPSED SIGNAGE SQ. FT.: 127.09 SQ. FT.			
	TOTAL SIGNAGE SQ. FT.: 300.26 SQ. FT.			


PROJECT:





HERITAGE TOWN SQUARE CENTER

21419 S ELLSWORTH RD QUEEN CREEK, AZ 85142

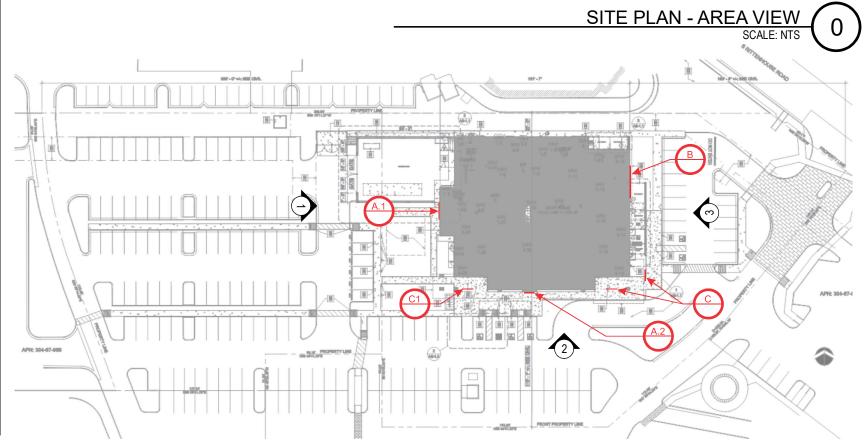




11 Azar Court • P.O. Box 24186 Baltimore, Maryland 21227 T: 410-247-5300 • F: 410 247-1944

Reproduction In Whole or Part Prohibited without Express Permission of Triangle S & S © TSS **CLIENT & LOCATION**



LEAD NO.	DATE	REVIEWED BY	SHEET NO.
206636 T5	5/16/2023		4 6 4 5
SM - PM	DRAWN BY	SEG. NO.	1 of 15
S. MOODY/S. WILEY	BZ		

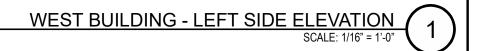



1.1 BUILDING PHOTO RENDERING
SCALE: NTS

R1 - CHANGED BACKER PANEL COLORS TO MATCH WALL.


R2 - CHANGED SIGN A.2 BACKER PANEL COLORS.

R3 - REMOVED ALL CABINET SIGN AND REPLACE WITH CHANNEL LETTERS

R4 - INCREASE SIGNS A.1 AND A.2 SIZES.

R6 - REMOVED LOGO ON SIGN A.1 AND INCREASED SIGNS A.1 AND A.2 SIZES.

R7 - INCREASED SIGNS A.1 LETTERS AND A.2 LOGO SIZES.

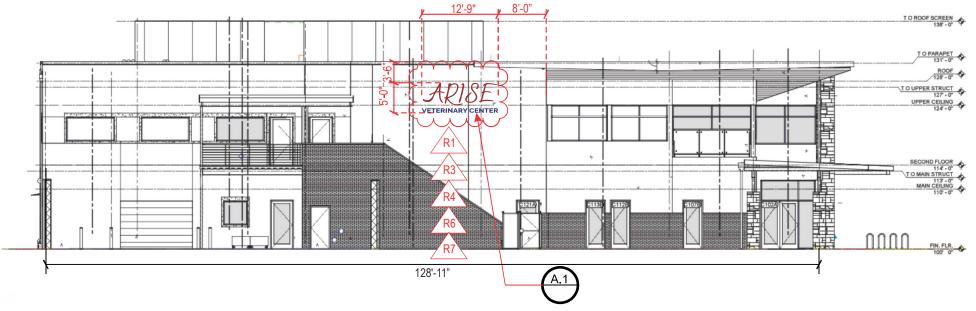



11 Azar Court • P.O. Box 24186 Baltimore, Maryland 21227 T: 410-247-5300 • F: 410 247-1944

Reproduction In Whole or Part Prohibited without Express Permission of Triangle S & S © TSS **CLIENT & LOCATION**



LEAD NO.	DATE	REVIEWED BY	SHEET NO.
206636 T5	5/16/2023		0 (45
SM - PM	DRAWN BY	SEG. NO.	2 of 15
S. MOODY/S. WILEY	BZ		

ADDED CH. LTRS TO DRAWING PACKAGE -


SOUTH BUILDING - FRONT ELEVATION

SCALE: 1/16" = 1'-0"

<u>|</u> (2



- R1 CHANGED BACKER PANEL COLORS TO MATCH WALL
- R2 CHANGED SIGN A.2 BACKER PANEL COLORS.
- R3 REMOVED ALL CABINET SIGN AND REPLACE WITH CHANNEL LETTERS
- R4 INCREASE SIGNS A.1 AND A.2 SIZES.
- R6 REMOVED LOGO ON SIGN A.1 AND INCREASED SIGNS A.1 AND A.2 SIZES.
- R7 INCREASED SIGNS A.1 LETTERS AND A.2 LOGO SIZES.
- R8 ADDED ELEVATION AND CHANNEL LETTERS SIGNS.

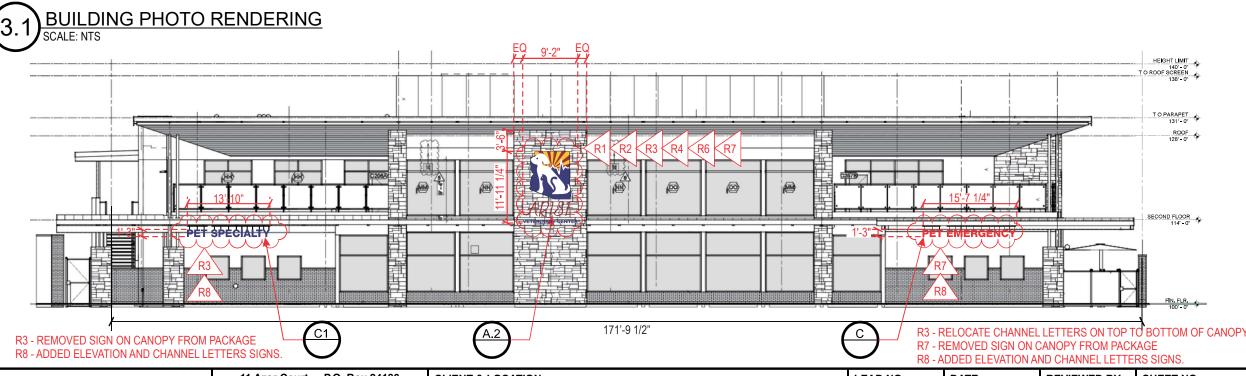

TRIANGLE SIGN SERVICES 11 Azar Court • P.O. Box 24186 Baltimore, Maryland 21227 T: 410-247-5300 • F: 410 247-1944

Reproduction In Whole or Part Prohibited without Express Permission of Triangle S & S © TSS **CLIENT & LOCATION**




LEAD NO.	DATE	REVIEWED BY	SHEET NO.
206636 T5	5/16/2023		0 (45
SM - PM	DRAWN BY	SEG. NO.	3 of 15
S. MOODY/S. WILEY	BZ		2
			•

ADDED TO DRAWING PACKAGE

EAST BUILDING - RIGHT SIDE ELEVATION

SCALF: 1/16" = 1'-0"



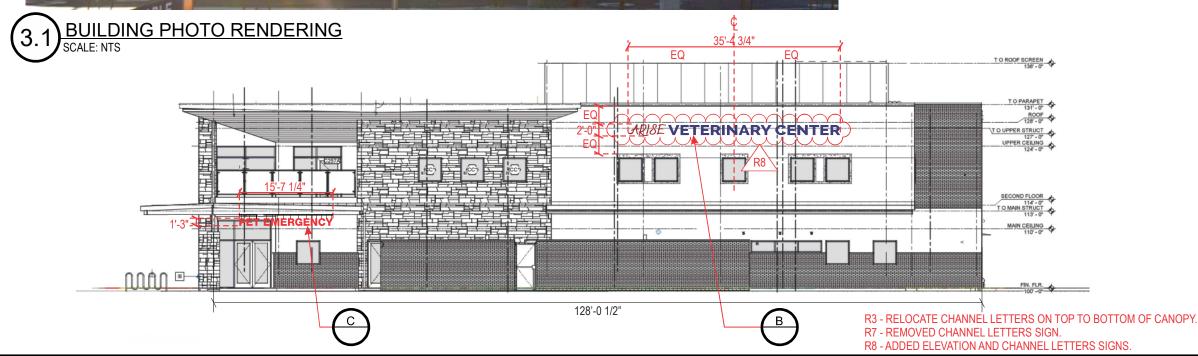



11 Azar Court • P.O. Box 24186 Baltimore, Maryland 21227 T: 410-247-5300 • F: 410 247-1944

Reproduction In Whole or Part Prohibited without Express Permission of Triangle S & S © TSS **CLIENT & LOCATION**



LEAD NO.	DATE	REVIEWED BY	SHEET NO.
206636 T5	5/16/2023		4 (45
SM - PM	DRAWN BY	SEG. NO.	4 of 15
S. MOODY/S. WILEY	BZ		



TRIANGLE SIGN SERVICES

11 Azar Court • P.O. Box 24186 Baltimore, Maryland 21227 T: 410-247-5300 • F: 410 247-1944

Reproduction In Whole or Part Prohibited without Express Permission of Triangle S & S © TSS




HERITAGE TOWN SQUARE CENTER 21419 S ELLSWORTH RD QUEEN CREEK, AZ 85142

EAD NO.	DATE	REVIEW
206636 T5	5/16/2023	
SM - PM	DRAWN BY	SEG. NO
. MOODY/S. WILEY	BZ	

5 of 15

22

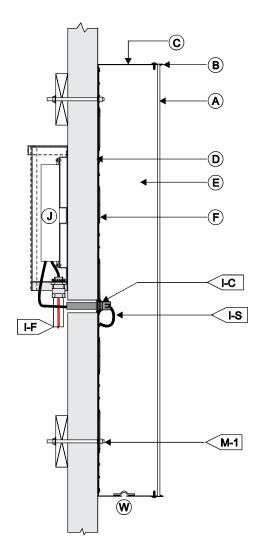

	LIT CHANNEL LOGO & LETTER / LED ILLUM. / EX		H MOUNTED SCALE: N.T.
(A) FACE		(I) WIRING	
MATERIAL:	3/16" #2447 WHITE ACRYLIC.	I-C	7/8" DIA. HOLE @ LEXAN W/ PAIGE WALL BUSTER
VINYL:	TRANSLUCENT VINYL FILM		CONNECTOR & CONDUIT.
COLOR INFO.:	MATCH CUSTOMER COLORS.	I-F	TO ELECTRICAL FEED
B TRIMCAPS		I-S	U.L. APPROVED LOW VOLTAGE CLASS II WIRING
SIZE / FINISH	1" / MATCH RETURNS		ALL CONNECTIONS TO BE IN WATERPROOF BOXES
© RETURNS			
DEPTH:	5"	J POWER SUPPLY	
MATERIAL:	ALUM040	TYPE:	REMOTE LED POWER SUPPLY HOUSE IN FRONT
COLOR:	MATCH CUSTOMER COLORS		ACCESS WEATHER-PROOF LED POWER SUPPLY BOX.
FINISH:	SATIN	VOLTAGE;	120V
D BACKS:		M MOUNTING	SEE MOUNTING NOTE.
MATERIAL:	3MM ACM	M-1	10/24 NUTSERT.
COLOR/FINISH:	WHITE SATIN		
E INSIDE OF CAN		W WEEP HOLES:	1/4" DIA. WITH COVER
COLOR:	PRE-COAT WHITE		
F ILLUMINATION:			
TYPE:	STANDARD 6500K WHITE LEDS		
	ALL WIRES TO BE TERMINATED W/ A	<u> </u>	
	MECHANICAL UL LISTED FASTENER		
			





- . CUSTOMER G.C. TO PROVIDE ADEQUATE WOOD OR MTL. BLOCKING IN CORRELATION W! FACADE FRAMING AS REQUIRED. I. INSTALLER IS TO VI.F. & PROVIDE THE PROPER NON-CORROSIVE MOUNTING HARDWARE TO ENSURE SAFE INSTALLATION.
- ALL EXTERIOR FACADE PENETRATIONS TO BE WATERTIGHT.
 INSTALLATION TO MEET CURRENT N.E.C., U.L. & LOCAL CODES.
 LOCATION OF THE DISCONNECT SWITCH AFTER INSTALLATION SHALL
 COMPLY WITH ARTICLE 600.6(A) (1) OF THE NATION ELECTRICAL CODE

ALL ELECTRICAL COMPONENTS TO BE U.L. APPROVED.
 CUSTOMER IS RESPONSIBLE FOR ONE (1) 120½ 20a DEDICATED CIRCUIT W/ GROUND PER SIGN TO WITHIN 6' OF SIGN.
 THIS SIGN IS INTENDED TO BE INSTALLED IN ACCORDING W/ THE

 THIS SIGN IS INTENDED TO BE INSTALLED IN ACCORDING WITHE REQUIREMENTS OF ARTICLE 600 OF THE NATIONAL ELECTRICAL CODE AND/OR OTHER APPLICABLE LOCAL CODES. THIS INCLUDES PROPER GROUNDING & BONDING OF THE SIGN. PLACEMENT OF LIGHTING ELEMENTS FOR OPTIMUM ILLUMINATION OF SIGN TO BE DETERMINED IN PRODUCTION.
 MANUFACTURER & U.L. LABELS TO BE APPLIED & VISIBLE FROM THE GROUND, LOCATED ON THE LAST CHANNEL LETTER OR END OF THE SIGN BOX/FREESTANDING SIGN

JL. LABELS TO BE APPLIED & VISIBLE FROM THE ON THE LAST CHANNEL LETTER OR END OF THE IDING SIGN

ALL ELECTRIC COMPONENTS





11 Azar Court • P.O. Box 24186 Baltimore, Maryland 21227 T: 410-247-5300 • F: 410 247-1944

Reproduction In Whole or Part Prohibited without Express Permission of Triangle S & S © TSS





AD NO.	SHEET NO.
06636 T5	0 (4)
- PM	6 of 15
OODY/S. WILEY	
- PM	6 of

SCALE:1/4" = 1'-0"




ADDED DRAWING TO PACKAGE

QTY: ONE (1)

ADDED SIGN TO FOR VARIANCE.

AREA SQ. FT.: 24" x 424.75" = 70.8 SQ. FT.

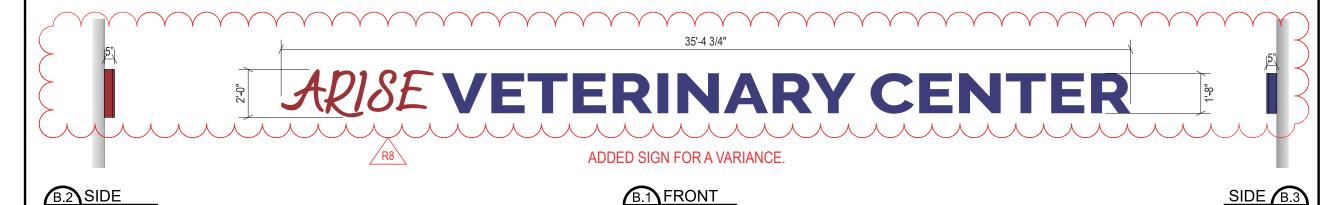

R8 - ADDED ELEVATION AND CHANNEL LETTERS SIGNS.




11 Azar Court • P.O. Box 24186 Baltimore, Maryland 21227 T: 410-247-5300 • F: 410 247-1944

Reproduction In Whole or Part Prohibited without Express Permission of Triangle S & S © TSS **CLIENT & LOCATION**



LEAD NO.	DATE	REVIEWED BY	SHEET NO.
206636 T5	5/16/2023		7 (45
SM - PM	DRAWN BY	SEG. NO.	7 of 15
S. MOODY/S. WILEY	BZ		2

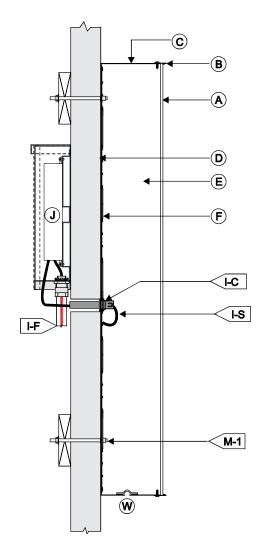

TRIMCAP FACE LIT CHANNEL LETTERS / LED ILLUM. / EXTERIOR INS		R INSTALL / FLUSH MOUN	NSTALL / FLUSH MOUNTED SCALE: N.T.S.		
		(I) WIRING			
MATERIAL:	3/16" #2447 WHITE ACRYLIC.	I-C	7/8" DIA. HOLE @ LEXAN W/ PAIGE WALL BUSTER		
VINYL:	TRANSLUCENT VINYL FILM		CONNECTOR & CONDUIT.		
COLOR INFO.:	MATCH CUSTOMER COLORS.	I-F	TO ELECTRICAL FEED		
B TRIMCAPS		I-S	U.L. APPROVED LOW VOLTAGE CLASS II WIRING		
SIZE / FINISH	1" / MATCH RETURNS		ALL CONNECTIONS TO BE IN WATERPROOF BOXES		
© RETURNS					
DEPTH:	5"	J POWER SUPPLY			
MATERIAL:	ALUM040	TYPE:	REMOTE LED POWER SUPPLY HOUSE IN FRONT		
COLOR:	MATCH CUSTOMER COLORS		ACCESS WEATHER-PROOF LED POWER SUPPLY BOX.		
FINISH:	SATIN	VOLTAGE;	120V		
D BACKS:		M MOUNTING	SEE MOUNTING NOTE.		
MATERIAL:	3MM ACM	M-1	10/24 NUTSERT.		
COLOR/FINISH:	WHITE SATIN	<u> </u>			
E INSIDE OF CAN		W WEEP HOLES:	1/4" DIA. WITH COVER		
COLOR:	PRE-COAT WHITE				
F ILLUMINATION:					
TYPE:	STANDARD 6500K WHITE LEDS				
	ALL WIRES TO BE TERMINATED W/ A				
	MECHANICAL UL LISTED FASTENER		•		



- . CUSTOMER G.C. TO PROVIDE ADEQUATE WOOD OR MTL. BLOCKING IN CORRELATION W FACADE FRAMING AS REQUIRED. 2. INSTALLER IS TO VI.F. & PROVIDE THE PROPER NON-CORROSIVE MOUNTING HARDWARE TO ENSURE SAFE INSTALLATION.
- ALL EXTERIOR FACADE PENETRATIONS TO BE WATERTIGHT.
 INSTALLATION TO MEET CURRENT N.E.C., U.L. & LOCAL CODES.
 LOCATION OF THE DISCONNECT SWITCH AFTER INSTALLATION SHALL
 COMPLY WITH ARTICLE 600.6(A) (1) OF THE NATION ELECTRICAL CODE
- ALL ELECTRICAL COMPONENTS TO BE U.L. APPROVED.
 CUSTOMER IS RESPONSIBLE FOR ONE (1) 120// 20a DEDICATED CIRCUIT W/ GROUND PER SIGN TO WITHIN 6' OF SIGN.
- THIS SIGN IS INTENDED TO BE INSTALLED IN ACCORDING W/ THE REQUIREMENTS OF ARTICLE 600 OF THE NATIONAL ELECTRICAL CODE AND/OR OTHER APPLICABLE LOCAL CODES. THIS INCLUDES PROPER GROUNDING & BONDING OF THE SIGN.

 PLACEMENT OF LIGHTING ELEMENTS FOR OPTIMUM ILLUMINATION OF SIGN TO BE DETERMINED IN PRODUCTION.
 MANUFACTURER & U.L. LABELS TO BE APPLIED & VISIBLE FROM THE

 MANUFACTURER & U.L. LABELS TO BE APPLIED & VISIBLE FROM THE GROUND. LOCATED ON THE LAST CHANNEL LETTER OR END OF THE SIGN BOX/FREESTANDING SIGN





11 Azar Court • P.O. Box 24186 Baltimore, Maryland 21227 T: 410-247-5300 • F: 410 247-1944

Reproduction In Whole or Part Prohibited without Express Permission of Triangle S & S © TSS





LEAD NO.	DATE	REVIEWED BY	SHEET NO.
206636 T5	5/16/2023		0 (45
SM - PM	DRAWN BY	SEG. NO.	8 of 15
S. MOODY/S. WILEY	BZ		

SCALE:1/2" = 1'-0"


QTY: TWO (2)

ADDED DRAWING TO PACKAGE

ADDED SIGN TO FOR VARIANCE.

AREA SQ. FT.: 15" x 187.25" = 19.5 SQ. FT.

TOTAL SQ. FT. = 39 SQ. FT.

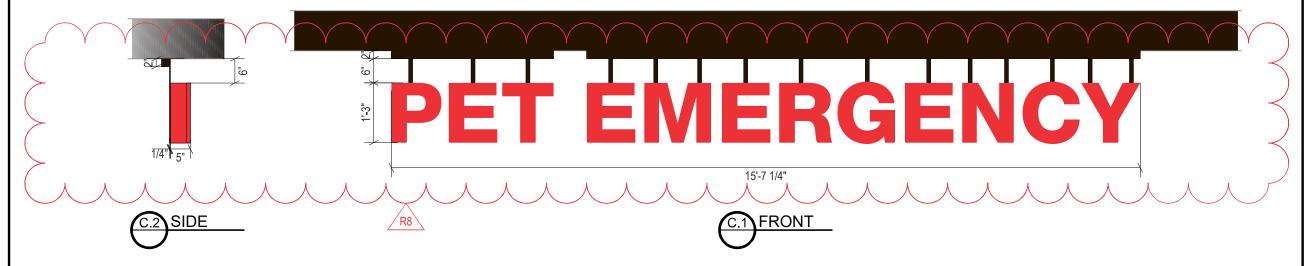



PET EMERGENCY

15'-7 1/4"

ALIGN WITH THE CURB BELLOW



R3 - RELOCATE CHANNEL LETTERS ON TOP TO BOTTOM OF CANOPY.

R7 - REMOVED CHANNEL LETTERS SIGN.

R8 - ADDED ELEVATION AND CHANNEL LETTERS SIGNS.





11 Azar Court • P.O. Box 24186 Baltimore, Maryland 21227 T: 410-247-5300 • F: 410 247-1944

Reproduction In Whole or Part Prohibited without Express Permission of Triangle S & S © TSS **CLIENT & LOCATION**




LEAD NO.	DATE	REVIEWED BY	SHEET NO.
206636 T5	5/16/2023		0 (45
SM - PM	DRAWN BY	SEG. NO.	9 of 15
6. MOODY/S. WILEY	BZ		

ILLUM. FACE-LIT, SUSPENDED CH LTRS with CUSTOM WIREWAY - SECTION DETAILS

SCALE: N.T.S.



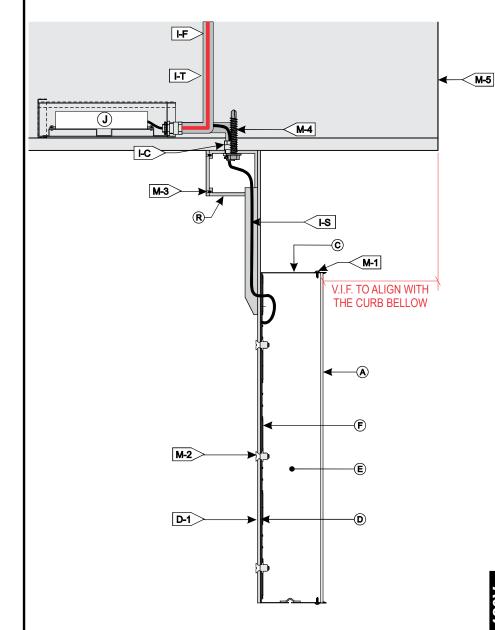

A) FACE	
MATERIAL:	3/16" #2447 WHITE ACRYLIC.
VINYL:	TRANSLUCENT VINYL FILM
COLOR INFO.:	RED TRANSLUCENT .
B TRIMCAPS:	
SIZE / FINISH	1" / MATCH RETURNS
C RETURNS	
DEPTH:	5"
MATERIAL:	ALUM040
COLOR:	RED
FINISH:	SATIN
D BACKS:	
MATERIAL:	ALUM.
D-1 PLATE:	1/4" ALUM. ROUTED LETTERS SHAPE WITH STEM
	WELDED TO FRONT OF WIREWAY.
COLOR/FINISH:	FINISHED TO MATCH CANOPY FASCIA
E) INSIDE OF CAN	
COLOR:	PRE-COAT WHITE
F) ILLUMINATION	
TYPE:	6500K WHITE LEDS
	ALL WIRES TO BE TERMINATED W/ A
	MECHANICAL UL LISTED FASTENER

<u> </u>	<u> </u>
(I) WIRING	
I-C:	1/2" CONNECTOR & CONDUIT.
I-F:	TO ELECTRICAL FEED
I-S:	U.L. APPROVED CLASS II LOW VOLTAGE WIRING FED
	FROM REMOTE P.S., THRU WIREWAY
	INTO BACKS OF LETTERS - SEALED TIGHT.
I-T:	LIQUID TITE from POWER SUPPLY BOX
J POWER SUPPLY	Υ
TYPE:	REMOTE LED POWER SUPPLY HOUSE IN FRONT
	ACCESS WEATHER-PROOF LED POWER SUPPLY BOX.
VOLTAGE:	120V
R WIREWAY	
TYPE:	2" x 2" x 1/8" ALUM. TUBE WITH BACK ACCESS.
FINISH:	MATCH DARK ANODIZED BRONZE CANOPY FASCIA
M MOUNTING	SEE MOUNTING NOTE.
M-1:	FLUSH-FITTING SCREWS.
M-2:	FLATHEAD SCREWS WITH NUTSERT THRU BACK PLATE
	AND INTO LETTERS.
M-3:	FLATHEAD SCREWS TO HOLD CLOSED.
COLOR:	FINISH TO MATCH FASCIA.
M-4:	3/8" DIA. MIN. SCREWS THRU WIREWAY AND INTO
M-5	EXISTING CANOPY
W WEEP HOLES:	
TYPE:	1/4" DIA. WITH COVER
	•



- CUSTOMER G.C. TO PROVIDE ADEQUATE WOOD OR MTL. BLOCKING IN CORRELATION W/ FACADE FRAMING AS REQUIRED.
- IN CORRELATION WI FACADE FRAMING AS REQUIRED.

 2. INSTALLER IS TO V.I.F. & PROVIDE THE PROPER NON-CORROSIVE MOUNTING HARDWARE TO ENSURE SAFE INSTALLATION.

 3. ALL EXTERIOR FACADE PENETRATIONS TO BE WATERTIGHT.

 ALL EXTERIOR FACADE PENETRATIONS TO BE WATERTIGHT.
 INSTALLATION TO MEET CURRENT N.E.C., U.L. & LOCAL CODES.
 LOCATION OF THE DISCONNECT SWITCH AFTER INSTALLATION SHALL COMPLY WITH ARTICLE 600.6(A) (1) OF THE NATION ELECTRICAL COD ALL ELECTRICAL COMPONENTS TO BE U.L. APPROVED.
 CUSTOMER IS RESPONSIBLE FOR ONE (1) 120v/ 20a DEDICATED CIRCUI'
W/ GROUND PER SIGN TO WITHIN 6' OF SIGN.

3. THIS SIGN IS INTENDED TO BE INSTALLED IN ACCORDING W/ THE REQUIREMENTS OF ARTICLE 600 OF THE NATIONAL ELECTRICAL CODE ANDIOR OTHER APPLICABLE LOCAL CODES. THIS INCLUDES PROPER GROUNDING & BONDING OF THE SIGN.

1. PLACEMENT OF LIGHTING ELEMENTS FOR OPTIMUM ILLUMINATION
OF SIGN TO BE DETERMINED IN PRODUCTION.
2. MANUFACTURED & LILL LABELS TO BE APPLIED & VISIBLE FROM THE

2. MANUFACTURER & U.L. LABELS TO BE APPLIED & VISIBLE FROM THE GROUND. LOCATED ON THE LAST CHANNEL LETTER OR END OF THE SIGN BOX/FREESTANDING SIGN





11 Azar Court • P.O. Box 24186 Baltimore, Maryland 21227 T: 410-247-5300 • F: 410 247-1944

Reproduction In Whole or Part Prohibited without Express Permission of Triangle S & S © TSS





LEAD NO.	DATE	REVIEWED BY	SHEET NO.
206636 T5	5/16/2023		40 (45
SM - PM	DRAWN BY	SEG. NO.	10 of 15
S. MOODY/S. WILEY	BZ		

SCALE:1/2" = 1'-0"

QTY: ONE (1)


SIGN C1

ADDED DRAWING TO PACKAGE

ADDED SIGN TO FOR VARIANCE.

``

AREA SQ. FT.: 15" x 166" = 17.29 SQ. FT.

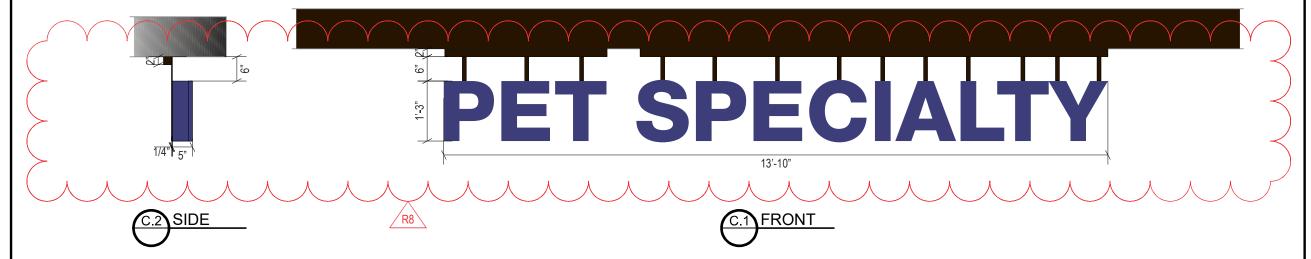



TRIANGLE

SIGN SERVICES


PET SPECIALTY

13'-10"

- ALIGN WITH THE CURB BELLOW



R3 - REMOVED SIGN ON CANOPY FROM PACKAGE. R8 - ADDED ELEVATION AND CHANNEL LETTERS SIGNS.

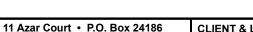

Reproduction In Whole or Part Prohibited without Express Permission of Triangle S & S © TSS

Baltimore, Maryland 21227

T: 410-247-5300 • F: 410 247-1944






LEAD NO.	DATE	REVIEWED BY	SHEET NO.
206636 T5	5/16/2023		44 (45
SM - PM	DRAWN BY	SEG. NO.	11 of 15
. MOODY/S. WILEY	BZ		

DARK ANODIZED BRONZE

ILLUM. FACE-LIT, SUSPENDED CH LTRS with CUSTOM WIREWAY - SECTION DETAILS



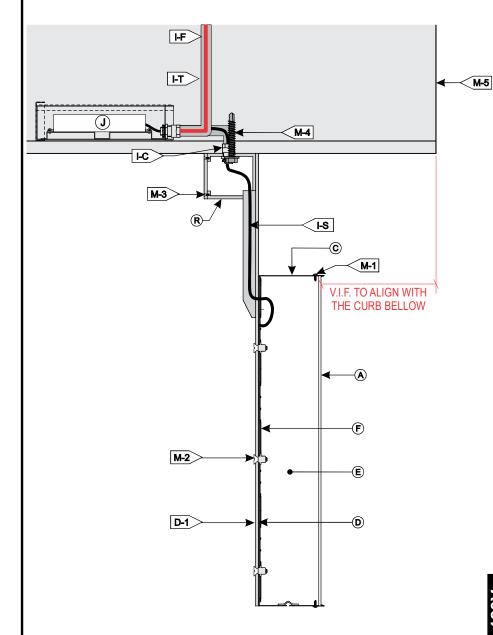

A) FACE	
MATERIAL:	3/16" #2447 WHITE ACRYLIC.
VINYL:	TRANSLUCENT VINYL FILM
COLOR INFO.:	BLUE TRANSLUCENT .
B TRIMCAPS:	
SIZE / FINISH	1" / MATCH RETURNS
© RETURNS	
DEPTH:	5"
MATERIAL:	ALUM040
COLOR:	BLUE
FINISH:	SATIN
D BACKS:	
MATERIAL:	ALUM.
D-1 PLATE:	1/4" ALUM. ROUTED LETTERS SHAPE WITH STEM
	WELDED TO FRONT OF WIREWAY.
COLOR/FINISH:	FINISHED TO MATCH CANOPY FASCIA
E) INSIDE OF CAN	
COLOR:	PRE-COAT WHITE
F ILLUMINATION	
TYPE:	6500K WHITE LEDS
	ALL WIRES TO BE TERMINATED W/ A
	MECHANICAL UL LISTED FASTENER

(I) WIRING	
I-C:	1/2" CONNECTOR & CONDUIT.
I-F:	TO ELECTRICAL FEED
I-S:	U.L. APPROVED CLASS II LOW VOLTAGE WIRING FED
	FROM REMOTE P.S., THRU WIREWAY
	INTO BACKS OF LETTERS - SEALED TIGHT.
I-T:	LIQUID TITE from POWER SUPPLY BOX
J POWER SUPPLY	Υ
TYPE:	REMOTE LED POWER SUPPLY HOUSE IN FRONT
	ACCESS WEATHER-PROOF LED POWER SUPPLY BOX.
VOLTAGE:	120V
R WIREWAY	
TYPE:	2" x 2" x 1/8" ALUM. TUBE WITH BACK ACCESS.
FINISH:	MATCH DARK ANODIZED BRONZE CANOPY FASCIA
M MOUNTING	SEE MOUNTING NOTE.
M-1:	FLUSH-FITTING SCREWS.
M-2:	FLATHEAD SCREWS WITH NUTSERT THRU BACK PLATE
	AND INTO LETTERS.
M-3:	FLATHEAD SCREWS TO HOLD CLOSED.
COLOR:	FINISH TO MATCH FASCIA.
M-4:	3/8" DIA. MIN. SCREWS THRU WIREWAY AND INTO
M-5	EXISTING CANOPY
W WEEP HOLES:	•
TYPE:	1/4" DIA. WITH COVER
-	
-	



- CUSTOMER G.C. TO PROVIDE ADEQUATE WOOD OR MTL. BLOCKING IN CORRELATION W/ FACADE FRAMING AS REQUIRED.
- INSTALLER IS TO V.I.F. & PROVIDE THE PROPER NON-CORROSIVE MOUNTING HARDWARE TO ENSURE SAFE INSTALLATION. 3. ALL EXTERIOR FACADE PENETRATIONS TO BE WATERTIGHT.
 4. INSTALLATION TO MEET CURRENT N.E.C., U.L. & LOCAL CODES.
- 1. ALL ELECTRICAL COMPONENTS TO BE U.L. APPROVED. CUSTOMER IS RESPONSIBLE FOR ONE (1) 120v/ 20a DEDICATED CIRCUIT w/ GROUND PER SIGN TO WITHIN 6' OF SIGN.
- W ORCOND FER SIGN TO WITHIN O OF SIGN IS MITTENDED TO BE INSTALLED IN ACCORDING W/ THE REQUIREMENTS OF ARTICLE 600 OF THE NATIONAL ELECTRICAL CODE AND/OR OTHER APPLICABLE LOCAL CODES. THIS INCLUDES PROPER

PLACEMENT OF LIGHTING ELEMENTS FOR OPTIMUM ILLUMINATION OF SIGN TO BE DETERMINED IN PRODUCTION. MANUFACTURER & U.L. LABELS TO BE APPLIED & VISIBLE FROM THE

GROUND. LOCATED ON THE LAST CHANNEL LETTER OR END OF THE SIGN BOX/ERFESTANDING SIGN





11 Azar Court • P.O. Box 24186 Baltimore, Maryland 21227 T: 410-247-5300 • F: 410 247-1944

Reproduction In Whole or Part Prohibited without Express Permission of Triangle S & S © TSS





HERITAGE TOWN SQUARE CENTER 21419 S ELLSWORTH RD QUEEN CREEK, AZ 85142

LEAD NO.	DATE	REVIEWED BY	SHEE
206636 T5	5/16/2023		
SM - PM	DRAWN BY	SEG. NO.	1
S. MOODY/S. WILEY	BZ		

ET NO. 12 of 15



R1 - ADDED A TAGLINE TO PYLON SIGN LOGO R2 - ADDED PYLON SIGN PANEL TEXTURE FINISH.



EXISTING



(A) FACE MATERIAL: 1/8" ALUM.. PAN ROUTED WITH LOGO. 2" RETURNS COLOR: SHERWIN WILLIAMS SW 6113 "INTERACTIVE CREAM" FINISH: PAINTED DRYVIT SANDPEBBLE FINE TEXTURE. A-1: BACKUP FLANGE MOUNTS WITH 10/24 STUDS & NUTS. A-2 PUSH THRU: 3/4" CLEAR ACRYLIC, ROUTED WITH 1/8" FLANGE AND WITH 1/2" PUSH-THRU. A-3 VINYL: DIGITAL PRINTED VINYL LOGO AND LETTERS APPLIED 1ST SURFACE OF PUSH-THRUS. COLOR/ FINISH: MATCH CUSTOMER COLORS / TRANSLUCENT. A-4 VINYL: WHITE TRANSLUCENT VINYL APPLIED 2ND SURFACE. (C) RETURNS DEPTH: MATERIAL: 1/8" ALUM. COLOR: SHERWIN WILLIAMS SW 6113 "INTERACTIVE CREAM" FINISH: PAINTED DRYVIT SANDPEBBLE FINE TEXTURE. (M) MOUNTING SEE MOUNTING NOTE MECHANICAL FASTENERS TO MATCH EXISTING. M-1: M-2: EXISTING MONUMENT SIGN FACE.

SW 6113 **Interactive Cream**



DRYVIT SANDPEBBLE FINE TEXTURE

PROPOSED




MONUMENT SIGN ELEVATION - ELLSWORTH RD SCALE: NTS

TRIANGLE SIGN SERVICES

11 Azar Court • P.O. Box 24186 Baltimore, Maryland 21227 T: 410-247-5300 • F: 410 247-1944

Reproduction In Whole or Part Prohibited without Express Permission of Triangle S & S © TSS

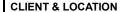



-<A-1

A-2 A-3

HERITAGE TOWN SQUARE CENTER 21419 S ELLSWORTH RD QUEEN CREEK, AZ 85142

LEAD NO.	DATE	REVIEWED BY	SHEET NO.
206636 T5	5/16/2023		40 (
SM - PM	DRAWN BY	SEG. NO.	13 of
S. MOODY/S. WILEY	BZ		

13 of 15



EXISTING



PROPOSED

MONUMENT SIGN ELEVATION - RITTENHOUSE RD SCALE: NTS

ALUM. PAN w/ PUSH-THRU LOGO/COPY FOR (E) MONUMENT SIGN


SCALE:3/8" = 1'-0"

D1

QTY: TWO (2)

11'-6" 11'-0" **EMERGENCY 24/7**

FRONT

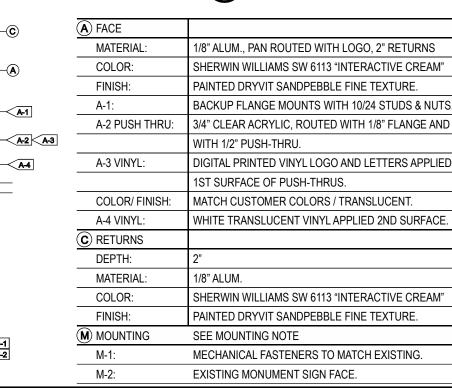

SW 6113 **Interactive Cream**





DRYVIT SANDPEBBLE FINE TEXTURE



11 Azar Court • P.O. Box 24186 Baltimore, Maryland 21227 T: 410-247-5300 • F: 410 247-1944

Reproduction In Whole or Part Prohibited without Express Permission of Triangle S & S © TSS **CLIENT & LOCATION**



HERITAGE TOWN SQUARE CENTER 21419 S ELLSWORTH RD QUEEN CREEK, AZ 85142

LEAD NO.	DATE	REVIEWED BY	SHEET NO.
206636 T5	5/16/2023		44.6
SM - PM	DRAWN BY	SEG. NO.	14 of
. MOODY/S. WILEY	BZ		

14 of 15



Project Narrative Requested by the technical review committee for the town of Queen Creek.

Arizona Regional Intensive Care located on Parcel 304-67-988A inside of Heritage Square is requesting Variance from the total aggregate wall sign area of up to 250 Square feet. Currently we have used 173.17 Square feet and the total additional signage we are requesting is 127.09 which would give us a total of 300.26 SF Requested. Please reference the shop drawings. ARISE (Arizona Regional intensive Care) is a multispecialty Veterinary Emergency and Specialty facility that houses 11 different medical specialties and state of the art equipment, some of which includes a CT, MRI Trailer, C-Arm, three X-Rays, and a Nu-boom etc. All these pieces of equipment will help to diagnose fix and cure the communities' animals. With being such a critical operation, we are in need of additional signage on our facility to ensure our building is easily seen by the public when seconds count. We have unfortunately had an incident where we lost a patient due to the owner not being able to find our facility when driving down Rittenhouse headed west since we do not have any signage on our East Elevation. It is for these types of scenarios that are critical and can be avoided which is why we are asking for Variance pertinent to additional signage square footage for our facility.

If you reference our most recent submittal, we are wanting to add an additional 4 signs two on the East Elevation Location B and Location C and two on the South Elevation Location C1 and Location C, Just for Clarification we have two location C Signs which are identical and will say "Emergency". The need for all the signs in the Variance package to be illuminated is imperative as we get majority of our critical patients in the late evening hours. We have added the "Emergency" Sign under the Southeast Canopy and the southwest Canopy, and we have added the "Pet Specialty" sign under the southwest Canopy. The objective for the sign placement for the under-canopy signs is to ensure that our clients have a visual on the Emergency and Specialty entrances, so they know not only where to enter but there is a 0% chance of confusion and our staff is able to access the patient as quick as possible when a critical comes in. For the Purpose of Clarification, the South side of the facility is considered the front and we are not requesting to add any signage on the North side of the facility which faces the Dairy Queen drive through.

Signature from Tenant:

Taylor David Rimsza

Digitally signed by Taylor David Rimsza

Div. C=U.S, E-drimsza@gnali.com, O="Deer

Taylor David Rimsza"

Valley Corporate Center *, CN="Taylor David Rimsza"

Date: 2023 05.12 09:09:41-0700*



11 Azar Court • P.O. Box 24186 Baltimore, Maryland 21227 T: 410-247-5300 • F: 410 247-1944

Reproduction In Whole or Part Prohibited without Express Permission of Triangle S & S © TSS **CLIENT & LOCATION**



LEAD NO.	DATE	REVIEWED BY	SHEET NO.
206636 T5	5/16/2023		45 645
SM - PM	DRAWN BY	SEG. NO.	15 of 15
S. MOODY/S. WILEY	BZ		